
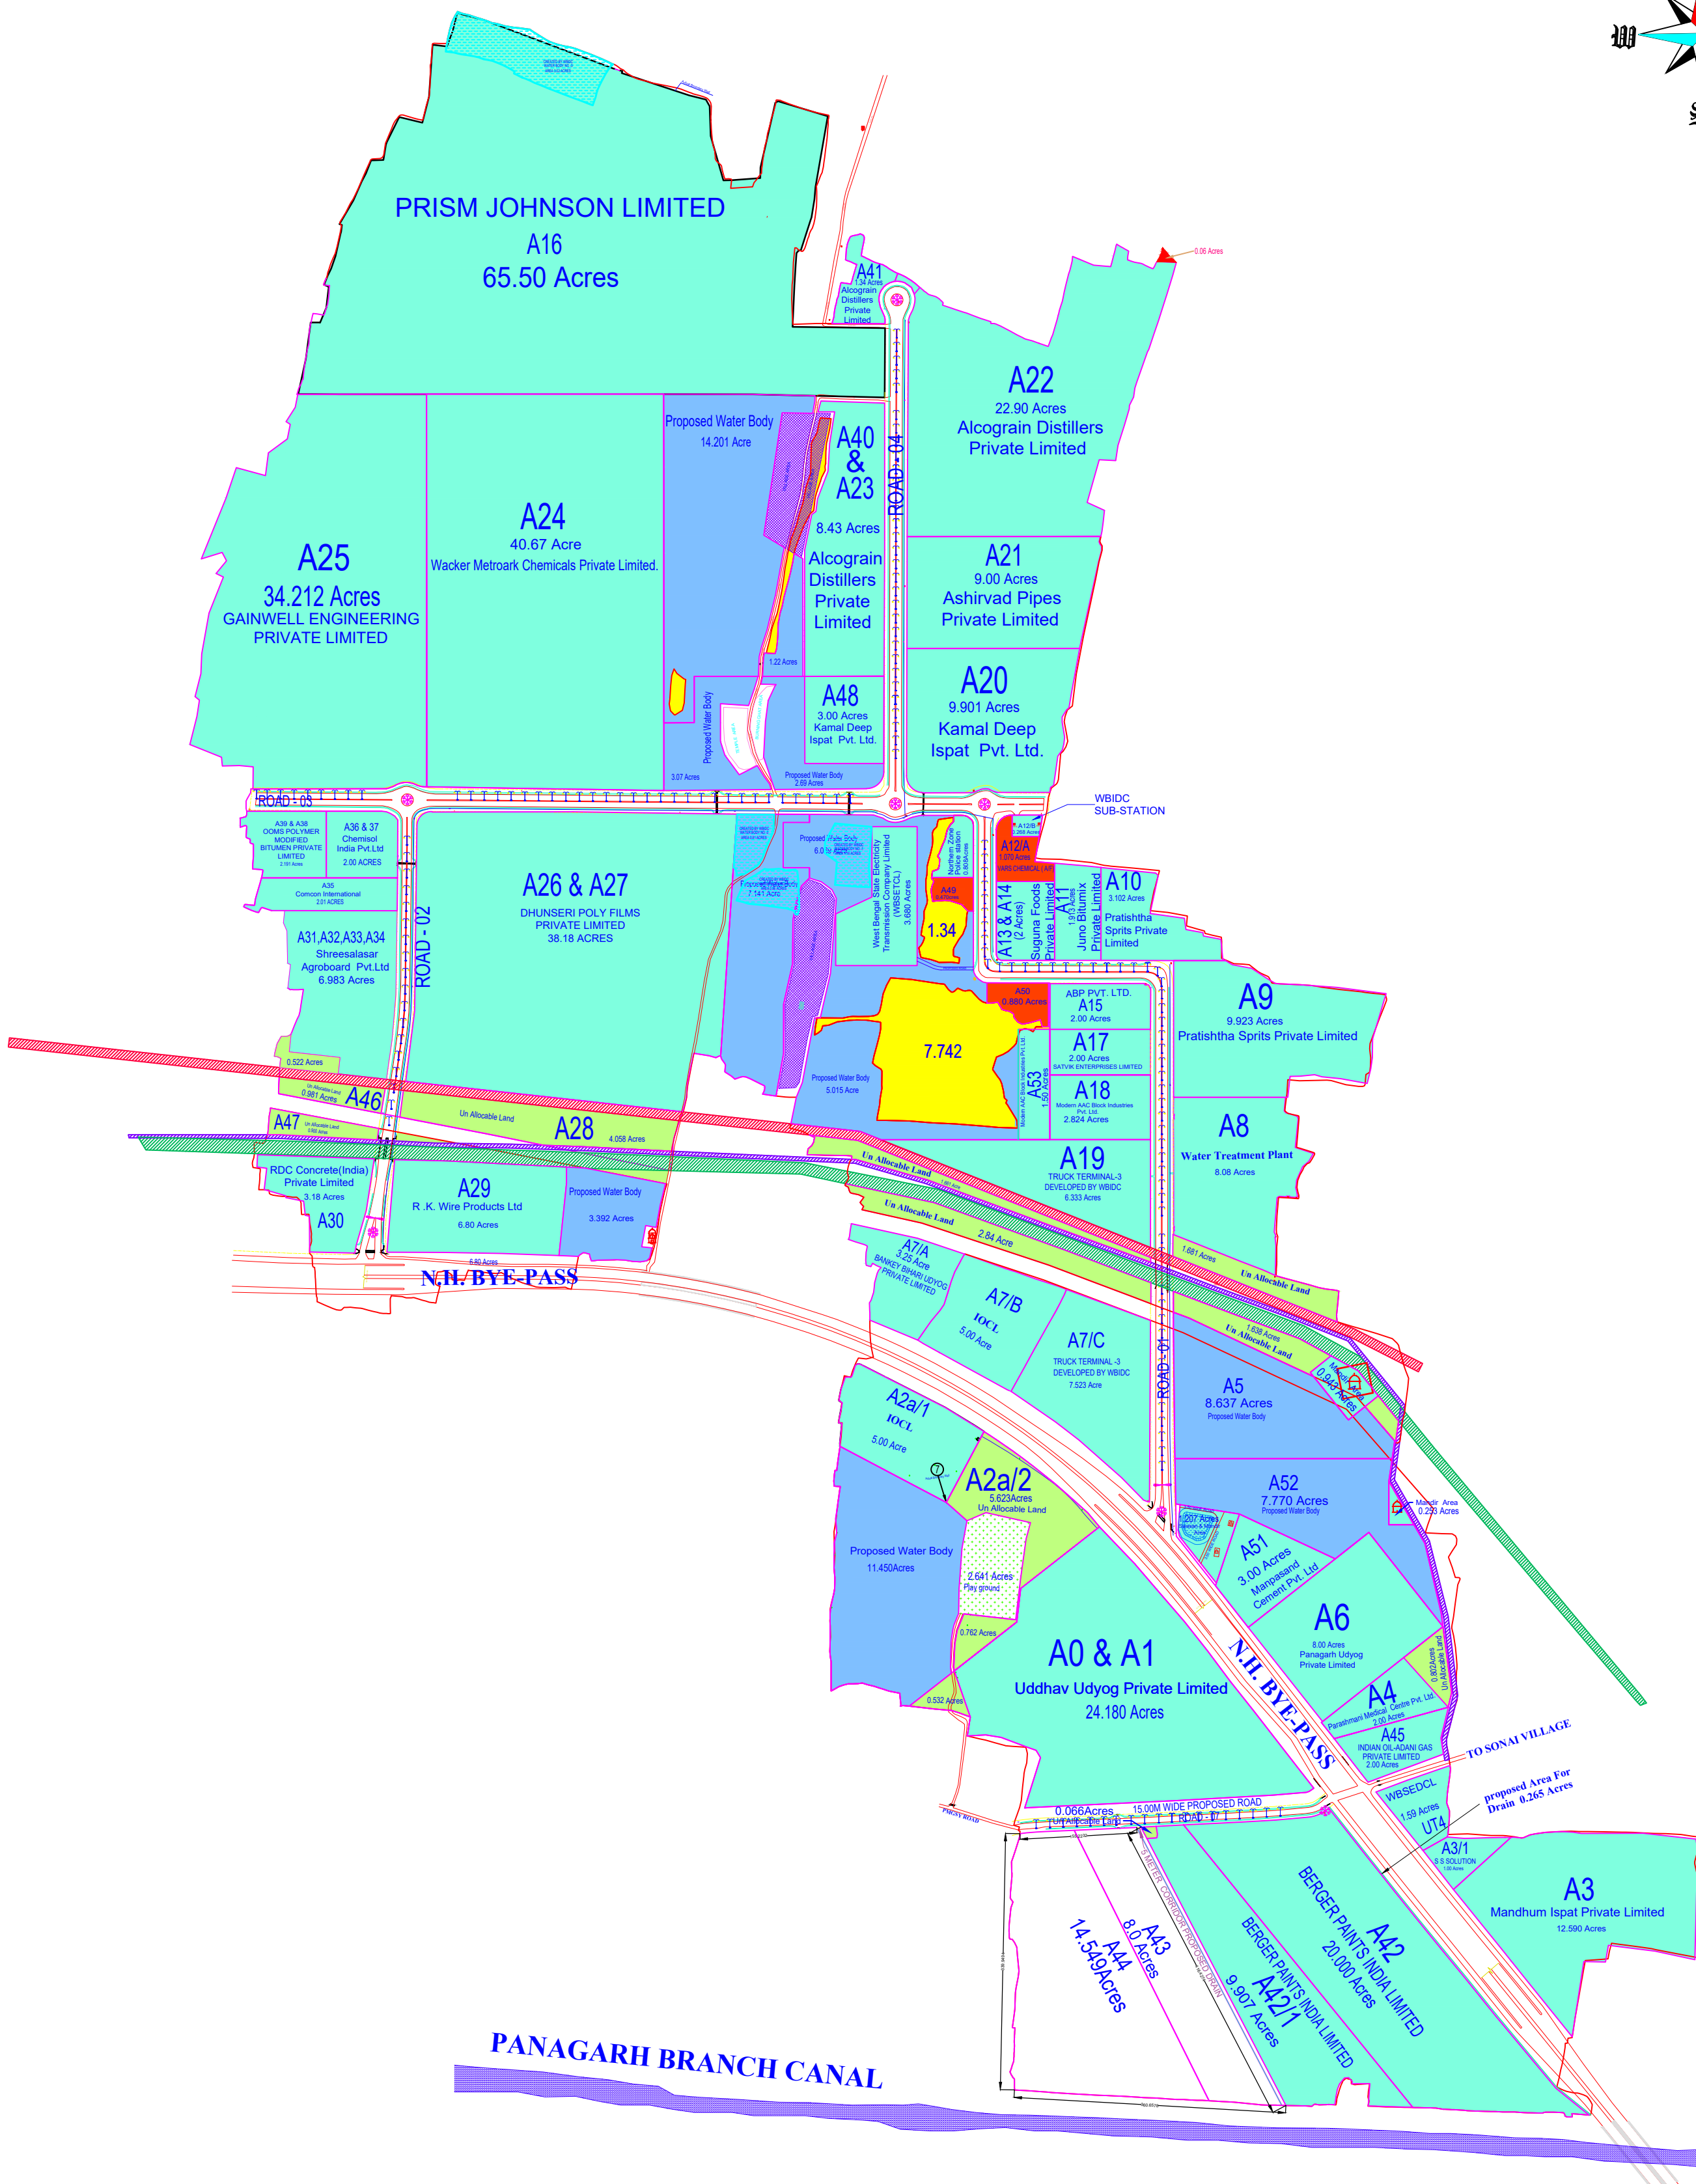


MASTER PLAN OF NORTHEN SIDE PANAGARH INDUSTRIAL PARK, PASHIM BARDHAMAN, WEST BENGAL

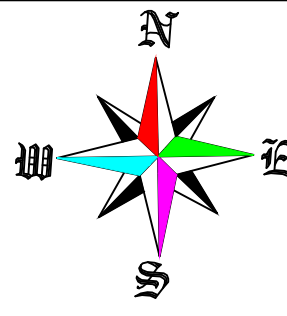

LEGEND	
RIVER	
BOUNDARY WALL	
BRIDGE	
CABAL CHAMBER	
CALVART	
DRAIN	
ELECTRIC POST	
ENCLOSMENT	
FEEDER BOX	
FLY OVER	
GATE	
HIGH MUST	
ICDS SCHOOL	
PLAY GROUND	
ROAD	
SASAN MONDIR AREA	
SDB BOX	
SLDB BOX	
STREET LIGHT	
SWITCH VALVE	
TAMPLE	
TRANSPORMA	
Rail Track	
Building	
P.I.P & M	
H.T TOWER	
IOC PIPE LINE	
ESSAR PIPE LINE	
UTILITY POWER CORRIDOR	

LIST OF REFERENCE MASTER PILLAR				
SL. NO.	NORTHING	EASTING	POINT ID	
1	2594564.2960	547755.873	PIP-1	
2	2594498.884	547880.418	PIP-2	
3	2592025.264	550225.563	PIP-3	
4	2591998.799	550364.777	PIP-4	
5	2595106.857	547612.132	PIP-5	
6	2595107.541	547644.785	PIP-6	
7	2591711.075	550996.303	PIP-7	
8	2591708.111	551020.854	PIP-8	

NOTES:-

1. All Dimensions Are In m. Unless Otherwise Noted.
2. All Coordinate Are In True Coordinate

CLIENT	West Bengal Industrial Development Corporation		
TITLE :	As Built MASTER PLAN AND TOPOGRAPHICAL SURVEY DRAWING OF NORTHEN SIDE PANAGARH INDUSTRIAL PARK		
Drawing No.:-	DWG NO. PAN/FTS - 001		
Work Order No.:-			
CONSULTANT:			
DRAWN+SURVEY	N.C.K	DATE	17.06.2025
DESIGNED			
CHECKED			
APPROVED			
Survey Agency		Rev.	0
SURVEYOR:	S S Solution AS-4/11, Srinagar Pally, Benachity, Durgapur-13 MOBILE:- 9434388866 Website:- www.sssolutiongroup.com EMAIL ID:- sssolution_88@rediffmail.		